

~~SECRET~~

CENTRAL INTELLIGENCE AGENCY


ATTACHMENT I

25X1A

Chemická továrna u Bystrovan
Chemical Factory near Bystrovan


Meritko:

Scale: 1 : 18,750

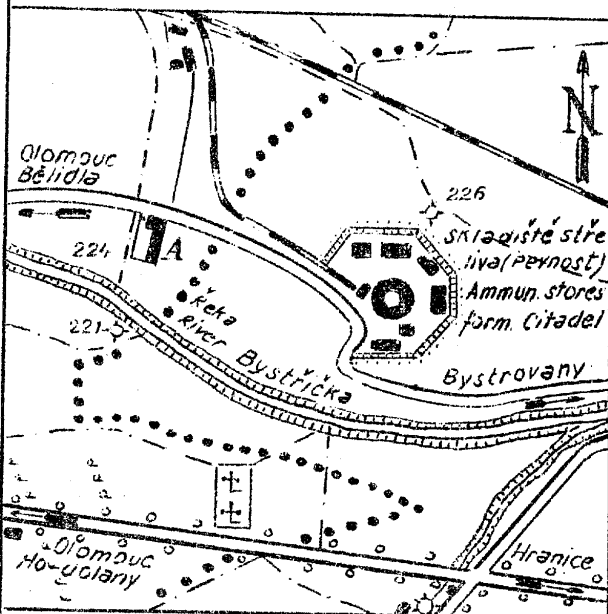

Detail "A"

Chemická továrna.
Chemical Factory.

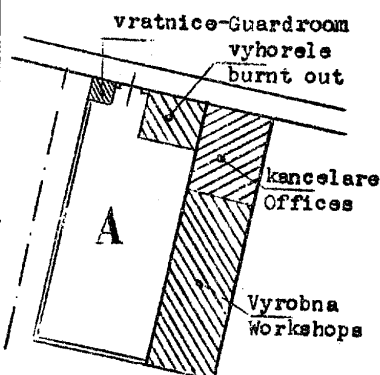


ATTACHMENT II

Sklad streliva "Ve Vypade" v Olomouci.
Ammunition Stores "Ve Vypade" at Olomouc.

Meritko:

Scale: 1 : 12,500

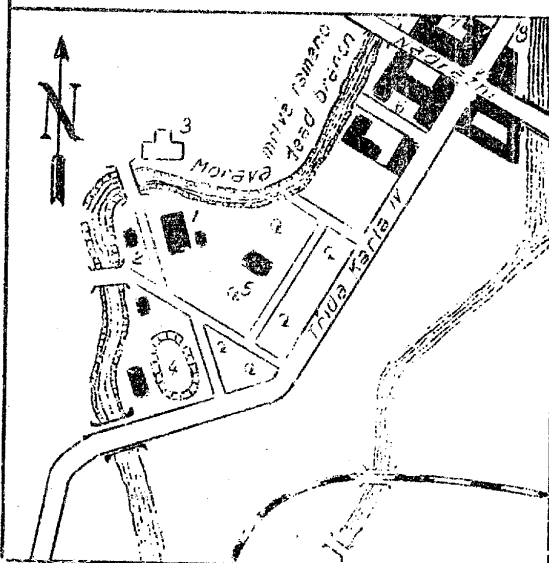

Legenda.

Legend.

- 1) Sklad streliva "Ve Vypade"
- 1) Ammunit. Stores "Ve Vypade"
- 2) Straznice - Guardroom
- 3) Pamatnik - Monument
- 4) Flovarna
- 4) Swimming pool
- 5) Mausoleum
- 6) Posadkove Velitelstvi
- 6) Garrison headquarters
- 7) Policejni Reditelstvi
- 7) Police headquarters
- 8) Doplnovaci Velitelstvi
- 8) Recruiting headquarters

~~SECRET~~